

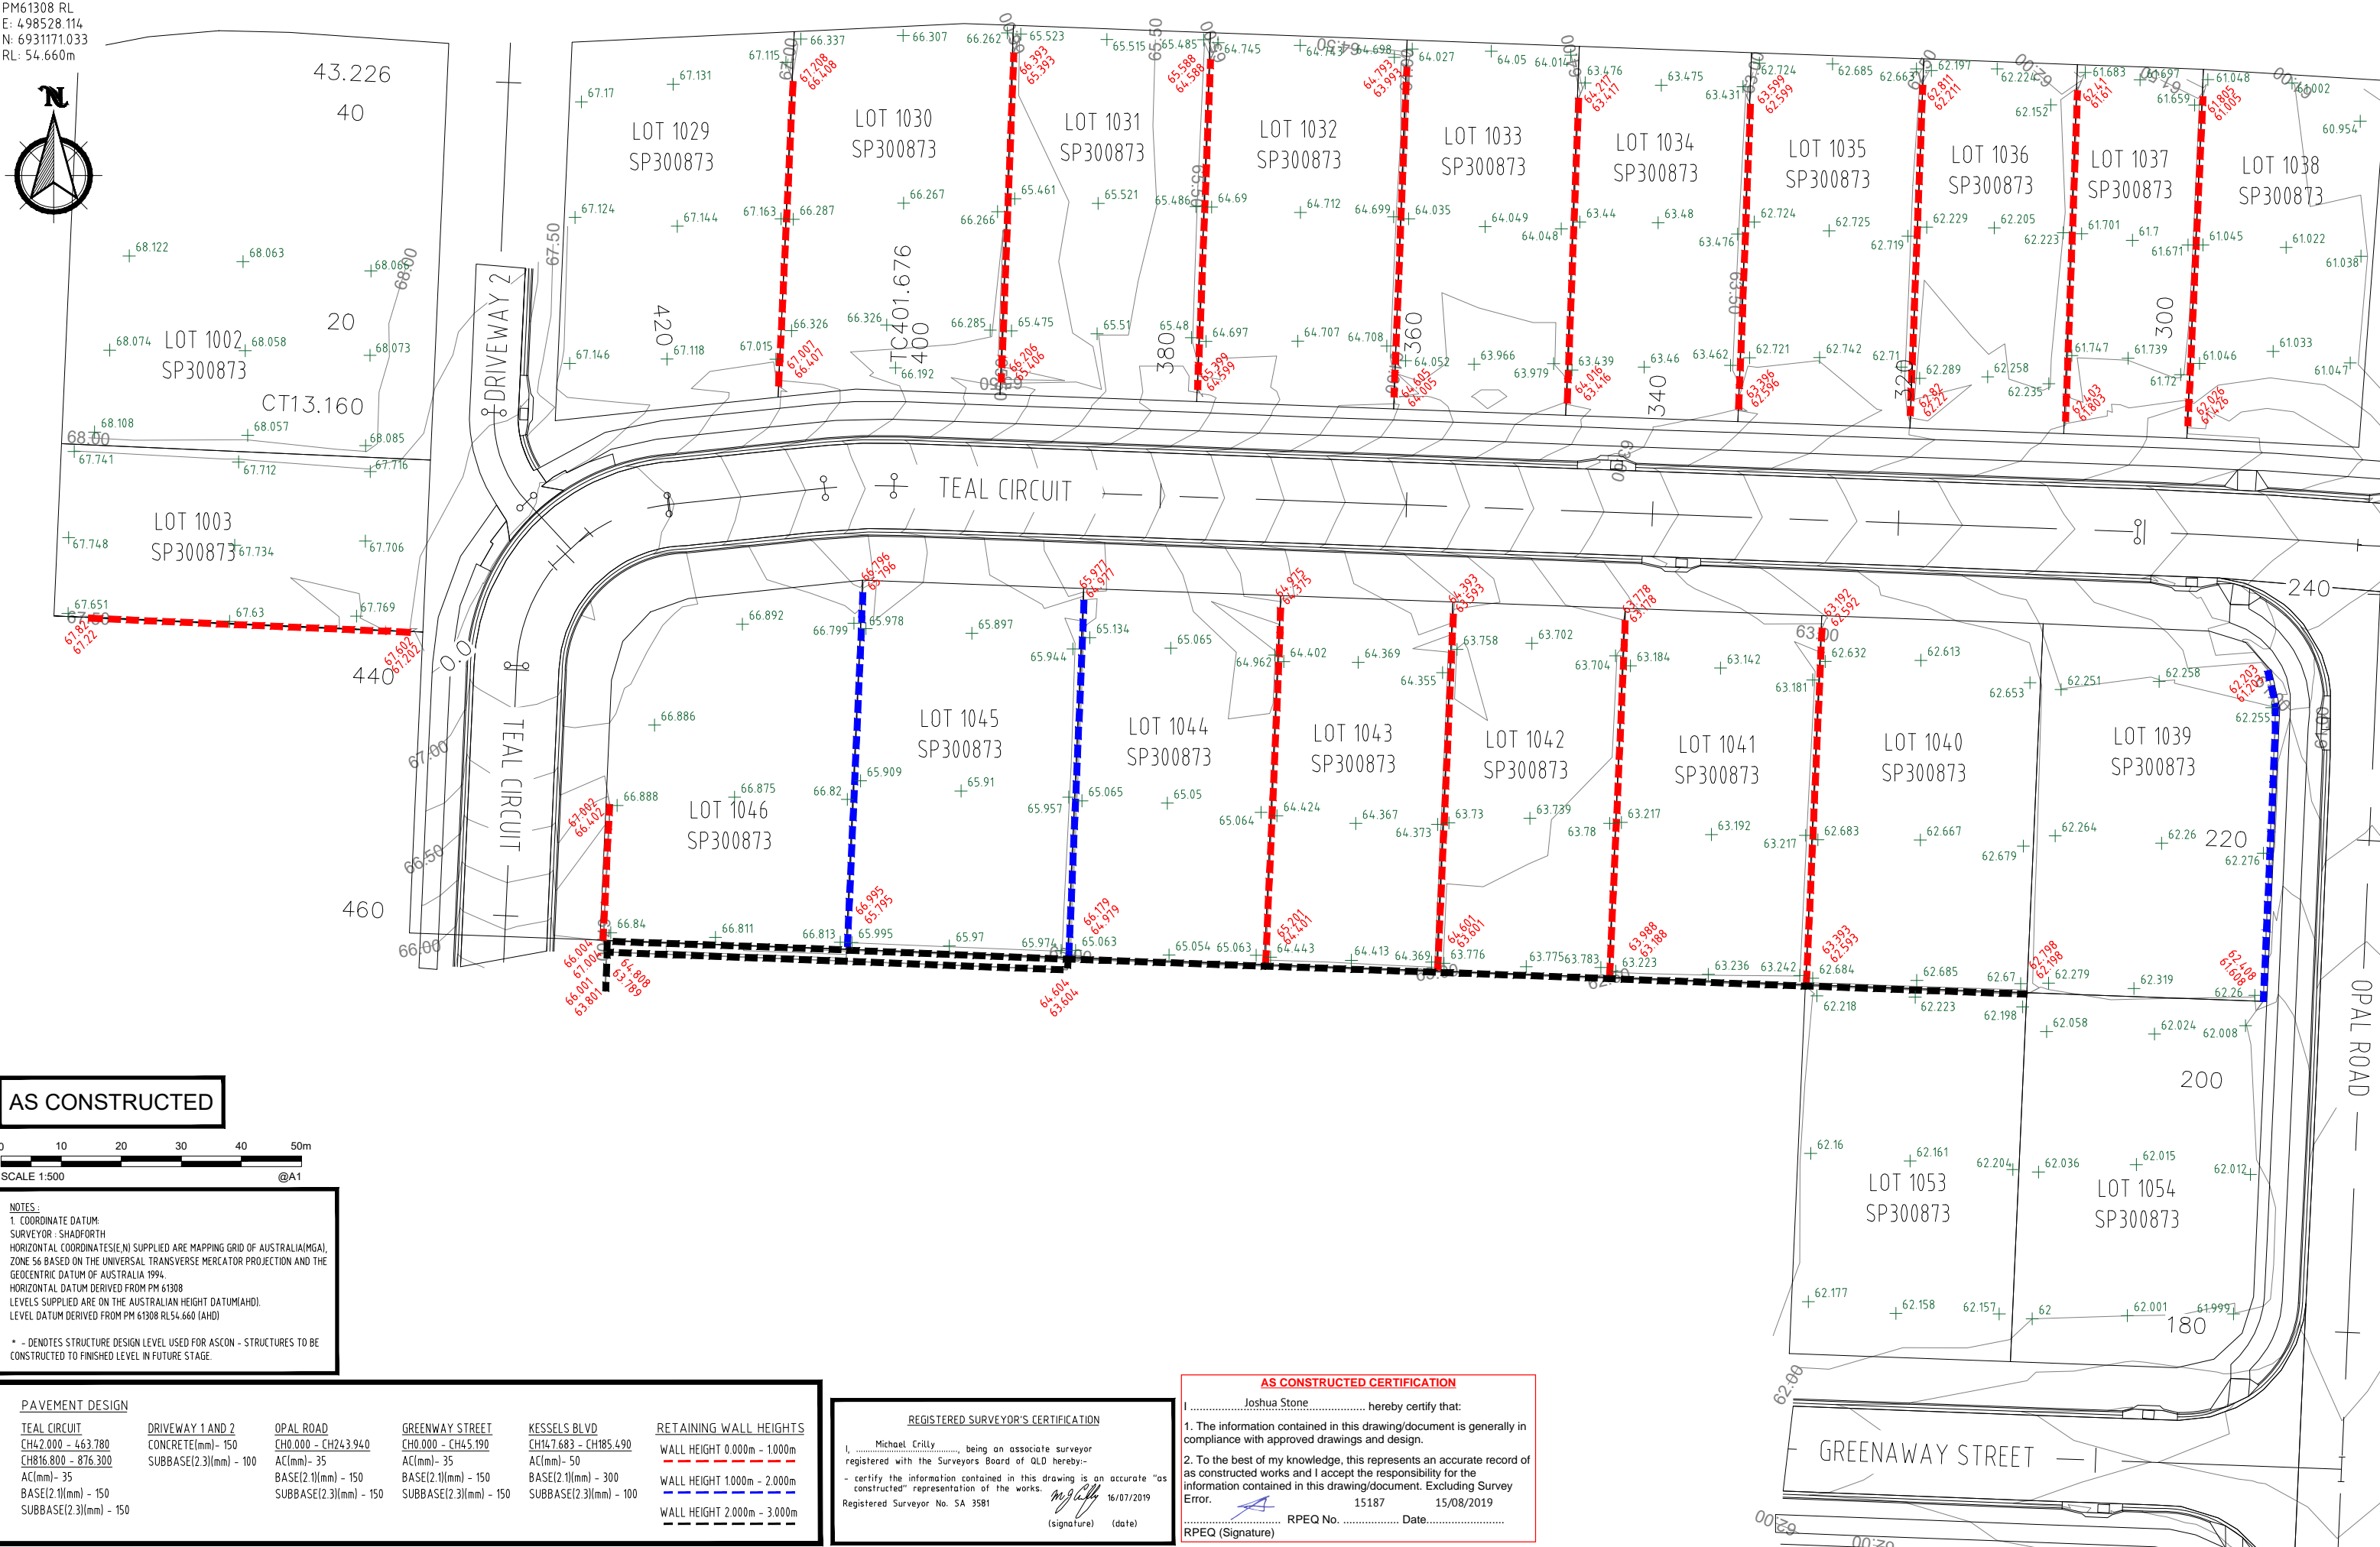


PM61308 RL  
E: 498528.114  
N: 6931171.033  
RL: 54.660m

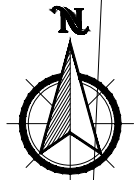

AS CONSTRUCTED

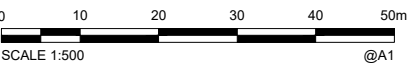

NOTES:  
1. COORDINATE DATUM:  
SURVEYOR - SHADFORTH  
HORIZONTAL COORDINATES(E,N) SUPPLIED ARE MAPPING GRID OF AUSTRALIA(MGA),  
ZONE 56 BASED ON THE UNIVERSAL TRANSVERSE MERCATOR PROJECTION AND THE  
GEOCENTRIC DATUM OF AUSTRALIA 1994,  
HORIZONTAL DATUM DERIVED FROM PM 61308  
LEVELS SUPPLIED ARE ON THE AUSTRALIAN HEIGHT DATUM(AHD),  
LEVEL DATUM DERIVED FROM PM 61308 RL54.660 (AHD)  
  
\* - DENOTES STRUCTURE DESIGN LEVEL USED FOR ASCON - STRUCTURES TO BE  
CONSTRUCTED TO FINISHED LEVEL IN FUTURE STAGE.

PAVEMENT DESIGN			
TEAL CIRCUIT	DRIVEWAY 1 AND 2	OPAL ROAD	GREENWAY STREET
CH42.000 - 463.780	CONCRETE(mm)- 150	CH0.000 - CH243.940	CH147.683 - CH185.490
CH816.800 - 876.300	SUBBASE(2.3)(mm) - 100	AC(mm)- 35	AC(mm)- 35
AC(mm)- 35		BASE(2.1)(mm) - 150	BASE(2.1)(mm) - 150
BASE(2.1)(mm) - 150		SUBBASE(2.3)(mm) - 150	SUBBASE(2.3)(mm) - 150
SUBBASE(2.3)(mm) - 150			SUBBASE(2.3)(mm) - 100

RETAINING WALL HEIGHTS			
WALL HEIGHT 0.000m - 1.000m			
WALL HEIGHT 1.000m - 2.000m			
WALL HEIGHT 2.000m - 3.000m			

REGISTERED SURVEYOR'S CERTIFICATION  
I, Michael Crilly, being an associate surveyor registered with the Surveyors Board of QLD hereby:-  
- certify the information contained in this drawing is an accurate "as constructed" representation of the works.  
Registered Surveyor No. SA 3581  
(signature) (date) 16/07/2019

AS CONSTRUCTED CERTIFICATION  
I, Joshua Stone, hereby certify that:  
1. The information contained in this drawing/document is generally in compliance with approved drawings and design.  
2. To the best of my knowledge, this represents an accurate record of as constructed works and I accept the responsibility for the information contained in this drawing/document. Excluding Survey Error.  
RPEQ (Signature) 15187 Date 15/08/2019  
RPEQ No. Date

A1												
A	16/07/2019	AS CONSTRUCTED		DAM	PJB	DB	PASSED	DB	16/07/2019			
INDEX	DATE	REVISIONS		DRAWN	CHECKED	PASSED		INITIALS	DATE			

10 Spadwood Lane, Forest Glen QLD 4055  
07 5488 3300 • 07 5488 3300 • shadforth@shadforth.com.au


LOGAN CITY COUNCIL

MIRVAC MIR001-03  
AS CONSTRUCTED SURVEY - ROADS AND EW  
EVERLEIGH PRECINCT 1.3 & 1.2A  
GREENBANK QLD

SHEET 1 OF 4 SHEETS  
REVISION DATE 16/07/2019  
DISCIPLINE CODE -  
DRAWING NO.  
ASC-ROADS AND EW-01-1.3&1.2A

SCALE 1500 A1  
REVISION A

PM61308 RL  
E: 498528.114  
N: 6931171.033  
RL: 54.660m

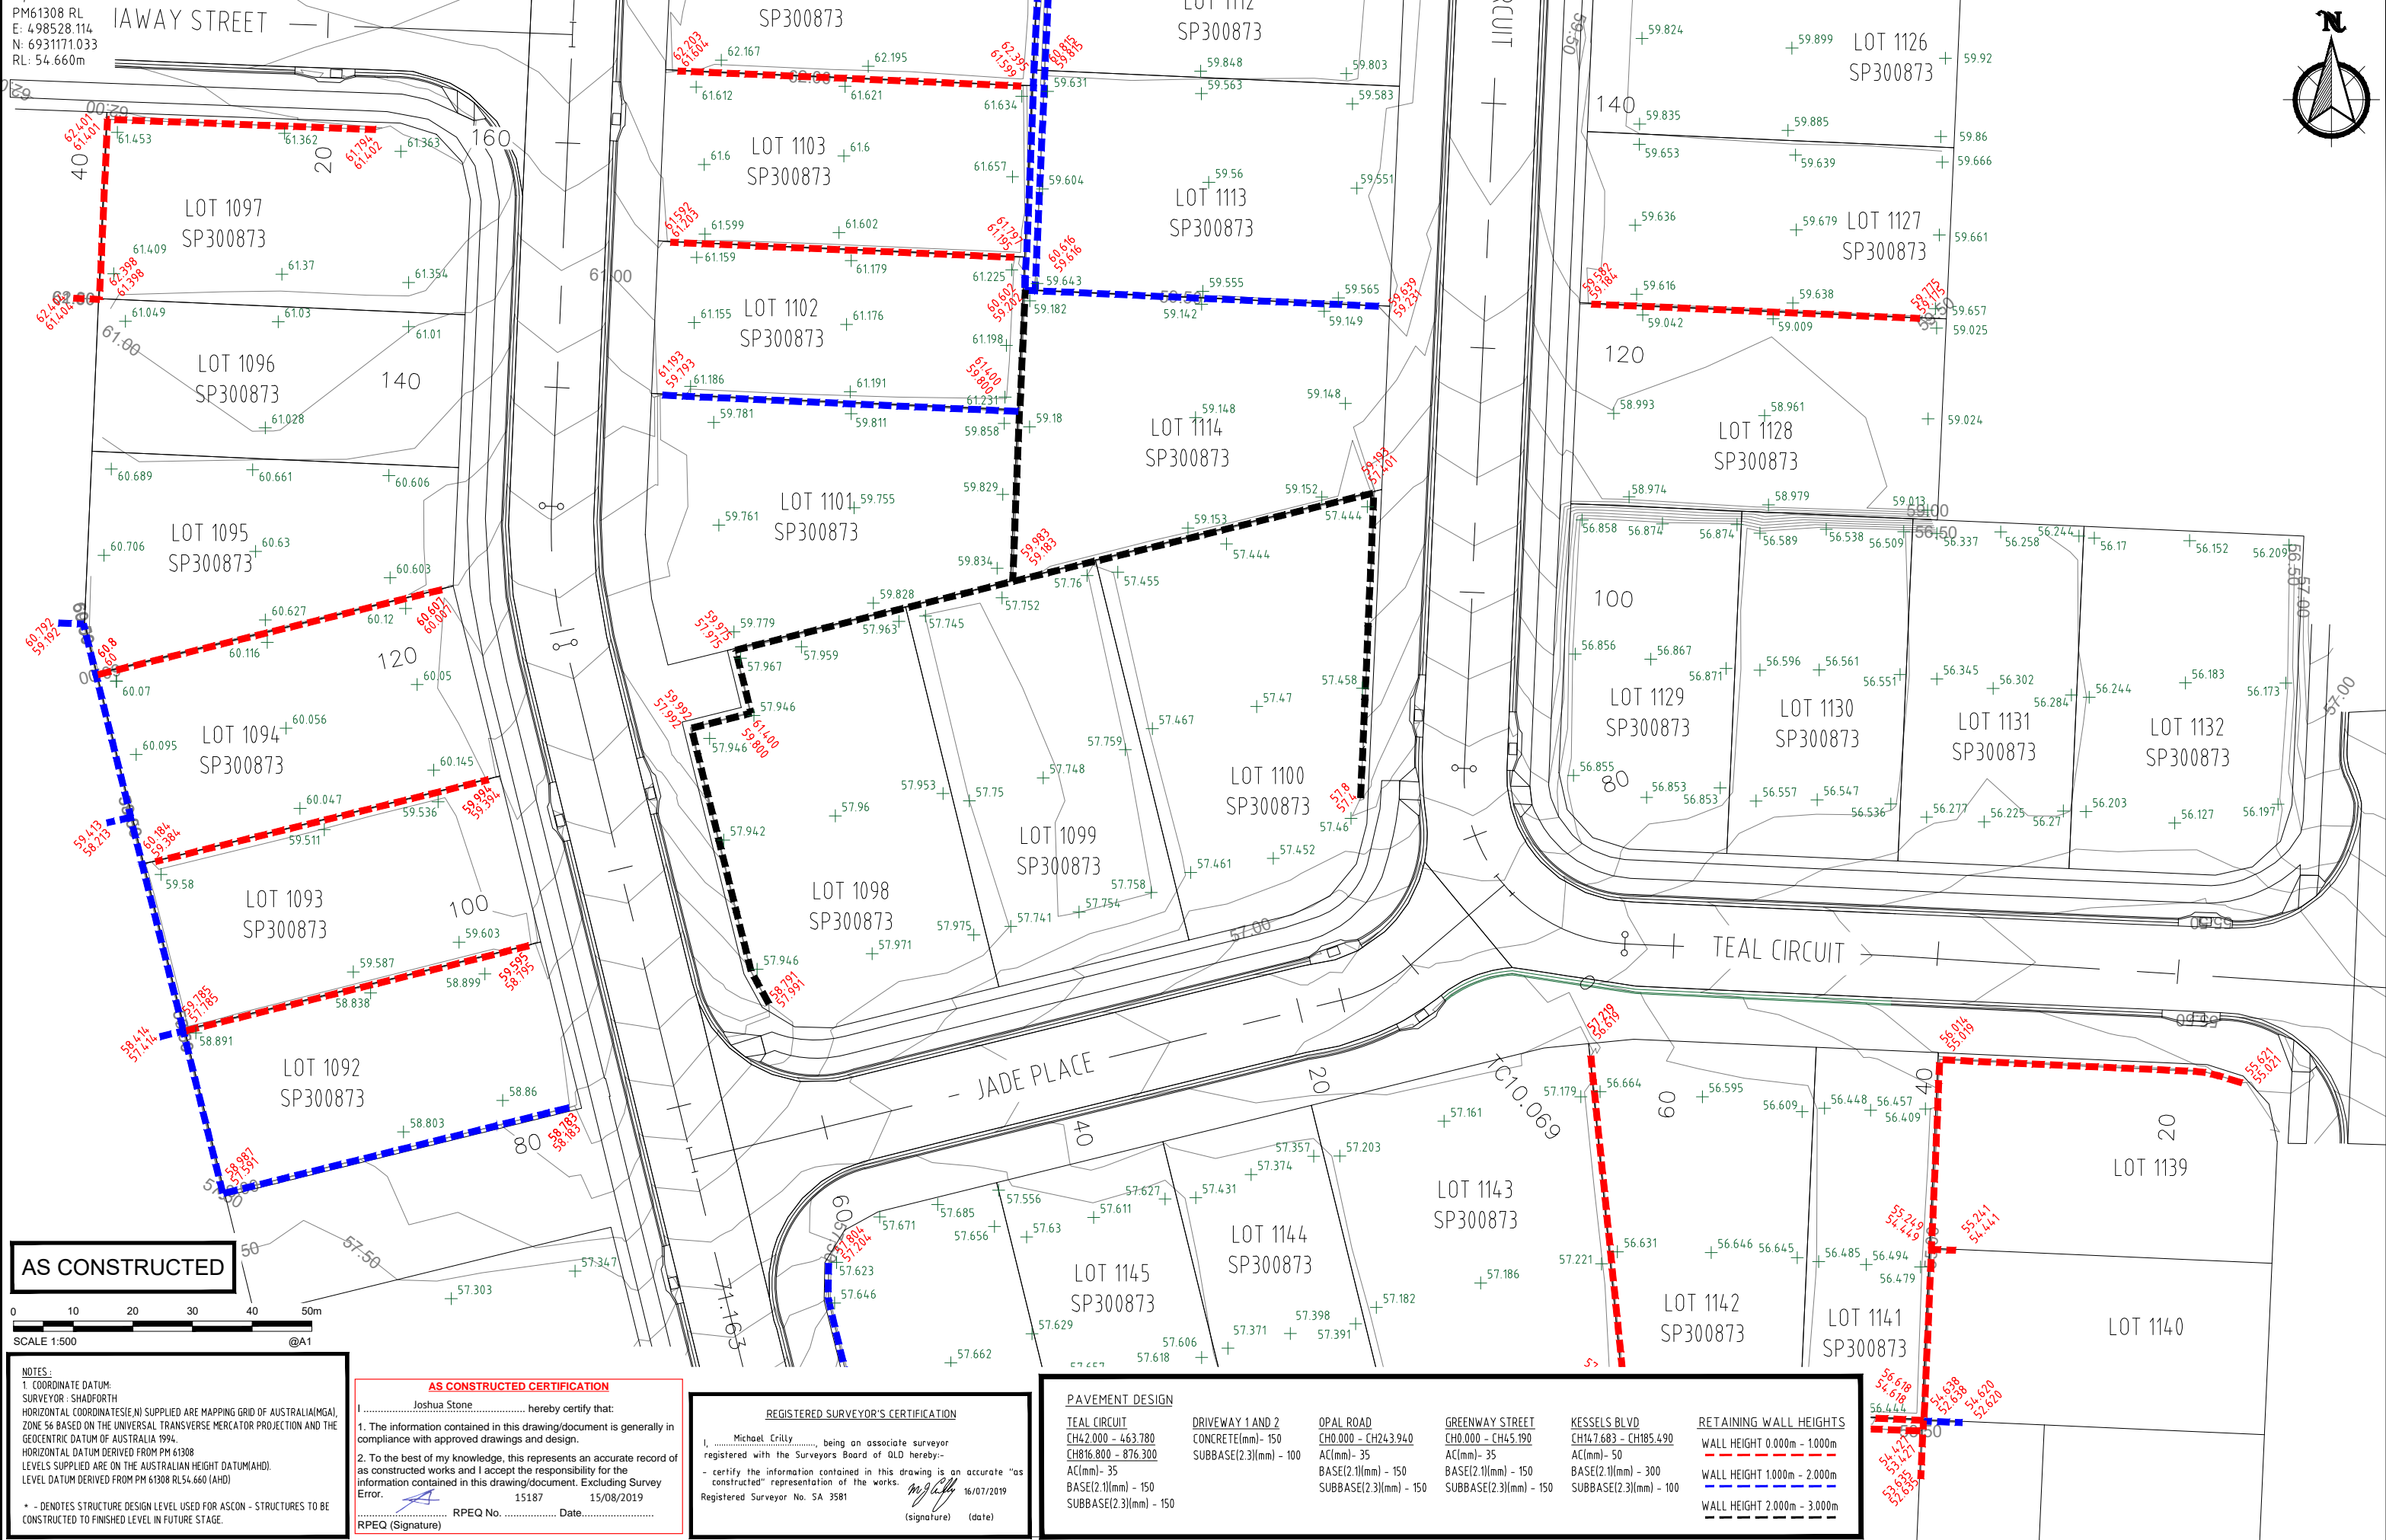

<b>A1</b>							DRAWN	DAM	16/07/2019
							CHECKED	PJB	16/07/2019
	A	16/07/2019	AS CONSTRUCTED		DAM	PJB	DB	PASSED	16/07/2019
	INDEX	DATE	REVISIONS	DRAWN	CHECKED	PASSED	INITIALS	DATE	




LOGAN CITY COUNCIL

MIRVAC MIR001-03  
AS CONSTRUCTED SURVEY - ROADS AND EW  
EVERLEIGH PRECINCT 1.3 & 1.2A  
GREENBANK QLD

SHEET 3 OF 4 SHEETS		SCALE 1:500 A1	
REVISION DATE	16/07/2019	REVISION	A
DISCIPLINE CODE		-	
DRAWING NO.			
ASC-ROADS AND EW-03-1.3&1.2A			



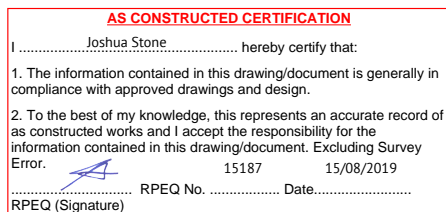

WALL HEIGHT 2.000m - 3.000m

SHEET 4 OF 4 SHEETS		SCALE 1:500 A1	
REVISION DATE	16/07/2019	REVISION	A
DISCIPLINE CODE	—		
DRAWING NO.			
ASC-ROADS AND EW-04-1.3&1.2A			



\* - DENOTES STRUCTURE DESIGN LEVEL USED FOR ASCON - STRUCTURES TO BE CONSTRUCTED TO FINISHED LEVEL IN FUTURE STAGE.

I, Michael Crilly, being an associate surveyor registered with the Surveyors Board of QLD hereby:-

- certify the information contained in this drawing is an accurate "as constructed" representation of the works.

Registered Surveyor No. SA 3581

*Michael Crilly* 16/07/2019

(signature) (date)

Joshua Stone ..... hereby certify that:  
 1. The information contained in this drawing/document is generally in compliance with approved drawings and design.  
 2. To the best of my knowledge, this represents an accurate record of as constructed works and I accept the responsibility for the information contained in this drawing/document. Excluding Survey Error.

RPEQ (Signature) ..... 15187 ..... 15/08/2019 .....  
 RPEQ No. .... Date.....

TEAL CIRCUIT  
CH42.000 - 463.780  
CH816.800 - 876.300  
AC(mm)- 35  
BASE(2.1)(mm) - 150  
SUBBASE(2.3)(mm) - 150


SUBBASE(2.3)(mm) - 100

CH0.000 - CH243.940  
AC(mm)- 35  
BASE(2.1)(mm) - 150  
SUBBASE(2.3)(mm) - 150

CH0.000 - CH45.190  
AC(mm)- 35  
BASE(2.1)(mm) - 150  
SUBBASE(2.3)(mm) - 150

AC(mm)- 50  
BASE(2.1)(mm) - 300  
SUBBASE(2.3)(mm) - 100

WALL HEIGHT 0.000m - 1.000m  
WALL HEIGHT 1.000m - 2.000m  
WALL HEIGHT 2.000m - 3.000m

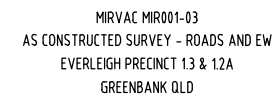[illegible]

SHEET 2 OF 4 SHEETS		SCALE 1:500 A1	
REVISION DATE	16/07/2019	REVISION	A
DISCIPLINE CODE	-		
DRAWING NO.			
ASC-ROADS AND EW-02-1.3&1.2A			