


REFER TO PLAN RDS & EWKS-02-10.3C

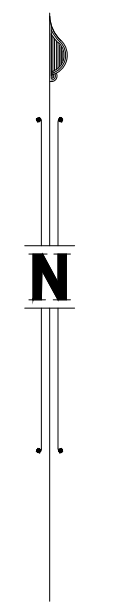

0 20 40 60 80 100m

SCALE 1:1000 @A1

SHEET 1 OF 5 SHEETS		SCALE 1:500 A1	
REVISION DATE	19/11/2024	REVISION	A
DISCIPLINE CODE	-		
DRAWING NO. ASC-RDS AND EWKS-01-10.3C			

PSM 61308
E: 498528.701
N: 6931172.420
RL: 54.660m

REGISTERED SURVEYOR'S CERTIFICATION

I, Dale Delaforce, hereby certify that the vertical and horizontal locations and dimensions shown on this plan are a true and correct record and were located by survey.

located by survey.

Registered Surveyor (sig) Ben. Surveyor No. 6176 Date: 19/11/2020



PAVEMENT DESIGN

PEACH AVENUE	GALAH WAY
AC(mm) - 35	AC(mm) - 35
BASE(2.1)(mm) - 150	BASE(2.1)(mm) - 150
SUBBASE(2.3)(mm) - 150	SUBBASE(2.3)(mm) - 150
LOTUS COURT	ROAD 106
AC(mm) - 35	AC(mm) - 35
BASE(2.1)(mm) - 150	BASE(2.1)(mm) - 150
SUBBASE(2.3)(mm) - 150	SUBBASE(2.3)(mm) - 100

III. HEIGHTS

	<u>SPOT HEIGHTS</u>	<u>WALL HEIGHTS</u>
+	56.36	56.600
		FF 521

RETAINING WALLS

ENGINEER'S CERTIFICATION

I,, hereby certify that:

1. The information contained in this drawing / document is in compliance with approved drawings and design.
2. This represents an accurate record of as-constructed works
3. I accept responsibility for the information contained in this drawing / document

RPEQ (signature) RPEQ No. Date:

AS CONSTRUCTED



A1

							DRAWN	RDE	19/11/2024
A	19/11/2024	AS CONSTRUCTED		RDE	DAM	CW	CHECKED	DAM	19/11/2024
INDEX	DATE	REVISIONS		DRAWN	CHECKED	PASSED	PASSED	INITIALS	DATE



LOGAN CITY COUNCIL

MIRVAC MIR-1003
AS CONSTRUCTED SURVEY - ROADS AND EARTHWORKS
EVERLEIGH PRECINCT 10.3C
GREENBANK QLD

SHEET 2 OF 5	SHEETS	SCALE	1:250 A1
REVISION DATE	19/11/2024	REVISION	A
DISCIPLINE CODE	-		
DRAWING NO.			
ASC-RDS AND EWKS-02-10.3C			

PSM 61308
E: 498528.701
N: 6931172.420
RL: 54.660m



COORDINATE DATUM NOTE:

HORIZONTAL COORDINATES(E,N) SUPPLIED ARE MAPPING GRID OF AUSTRALIA(MGA), ZONE 56 BASED ON THE UNIVERSAL TRANSVERSE MERCATOR PROJECTION AND THE GEOCENTRIC DATUM OF AUSTRALIA 2020.
HORIZONTAL DATUM DERIVED FROM PSM 61308 E 498528.701 N 6931172.420.
LEVELS SUPPLIED ARE ON THE AUSTRALIAN HEIGHT DATUM(AHD) LEVEL DATUM DERIVED FROM PSM 61308 RL54.660 (AHD)

PAVEMENT DESIGN

PEACH AVENUE	GALAH WAY
AC(mm) - 35	AC(mm) - 35
BASE(2.1)(mm) - 150	BASE(2.1)(mm) - 150
SUBBASE(2.3)(mm) - 150	SUBBASE(2.3)(mm) - 150
LOTUS COURT	ROAD 106
AC(mm) - 35	AC(mm) - 35
BASE(2.1)(mm) - 150	BASE(2.1)(mm) - 150
SUBBASE(2.3)(mm) - 150	SUBBASE(2.3)(mm) - 100

SPOT HEIGHTS	WALL HEIGHTS
+ 56.36	55.600
	55.524

RETAINING WALLS

REGISTERED SURVEYOR'S CERTIFICATION

I, _____, Date DeLaforce, hereby certify that the vertical and horizontal locations and dimensions shown on this plan are a true and correct record and were located by survey.

Registered Surveyor (sig.) _____ Reg. Surveyor No. 6176 Date: 19/11/2024

ENGINEER'S CERTIFICATION

- I, _____, hereby certify that:
- The information contained in this drawing / document is in compliance with approved drawings and design.
 - This represents an accurate record of as-constructed works
 - I accept responsibility for the information contained in this drawing / document

RPEQ (signature) _____ RPEQ No. _____ Date: _____

AS CONSTRUCTED

0 5 10 15 20 25m
SCALE 1:250
@A1

A1

INDEX	DATE	AS CONSTRUCTED	REVISIONS	DRAWN	CHECKED	PASSED
A	19/11/2024	AS CONSTRUCTED		RDE	DAM	CW


DRAWN	RDE	19/11/2024
CHECKED	DAM	19/11/2024
PASSED	CW	19/11/2024
INITIALS	DATE	



LOGAN CITY COUNCIL

MIRVAC MIR-1003
AS CONSTRUCTED SURVEY - ROADS AND EARTHWORKS
EVERLEIGH PRECINCT 10.3C
GREENBANK QLD

SHEET 3 OF 5 SHEETS	SCALE 1:250 A1
REVISION DATE 19/11/2024	REVISION A
DISCIPLINE CODE -	
DRAWING NO.	
ASC-RDS AND EWKS-03-10.3C	

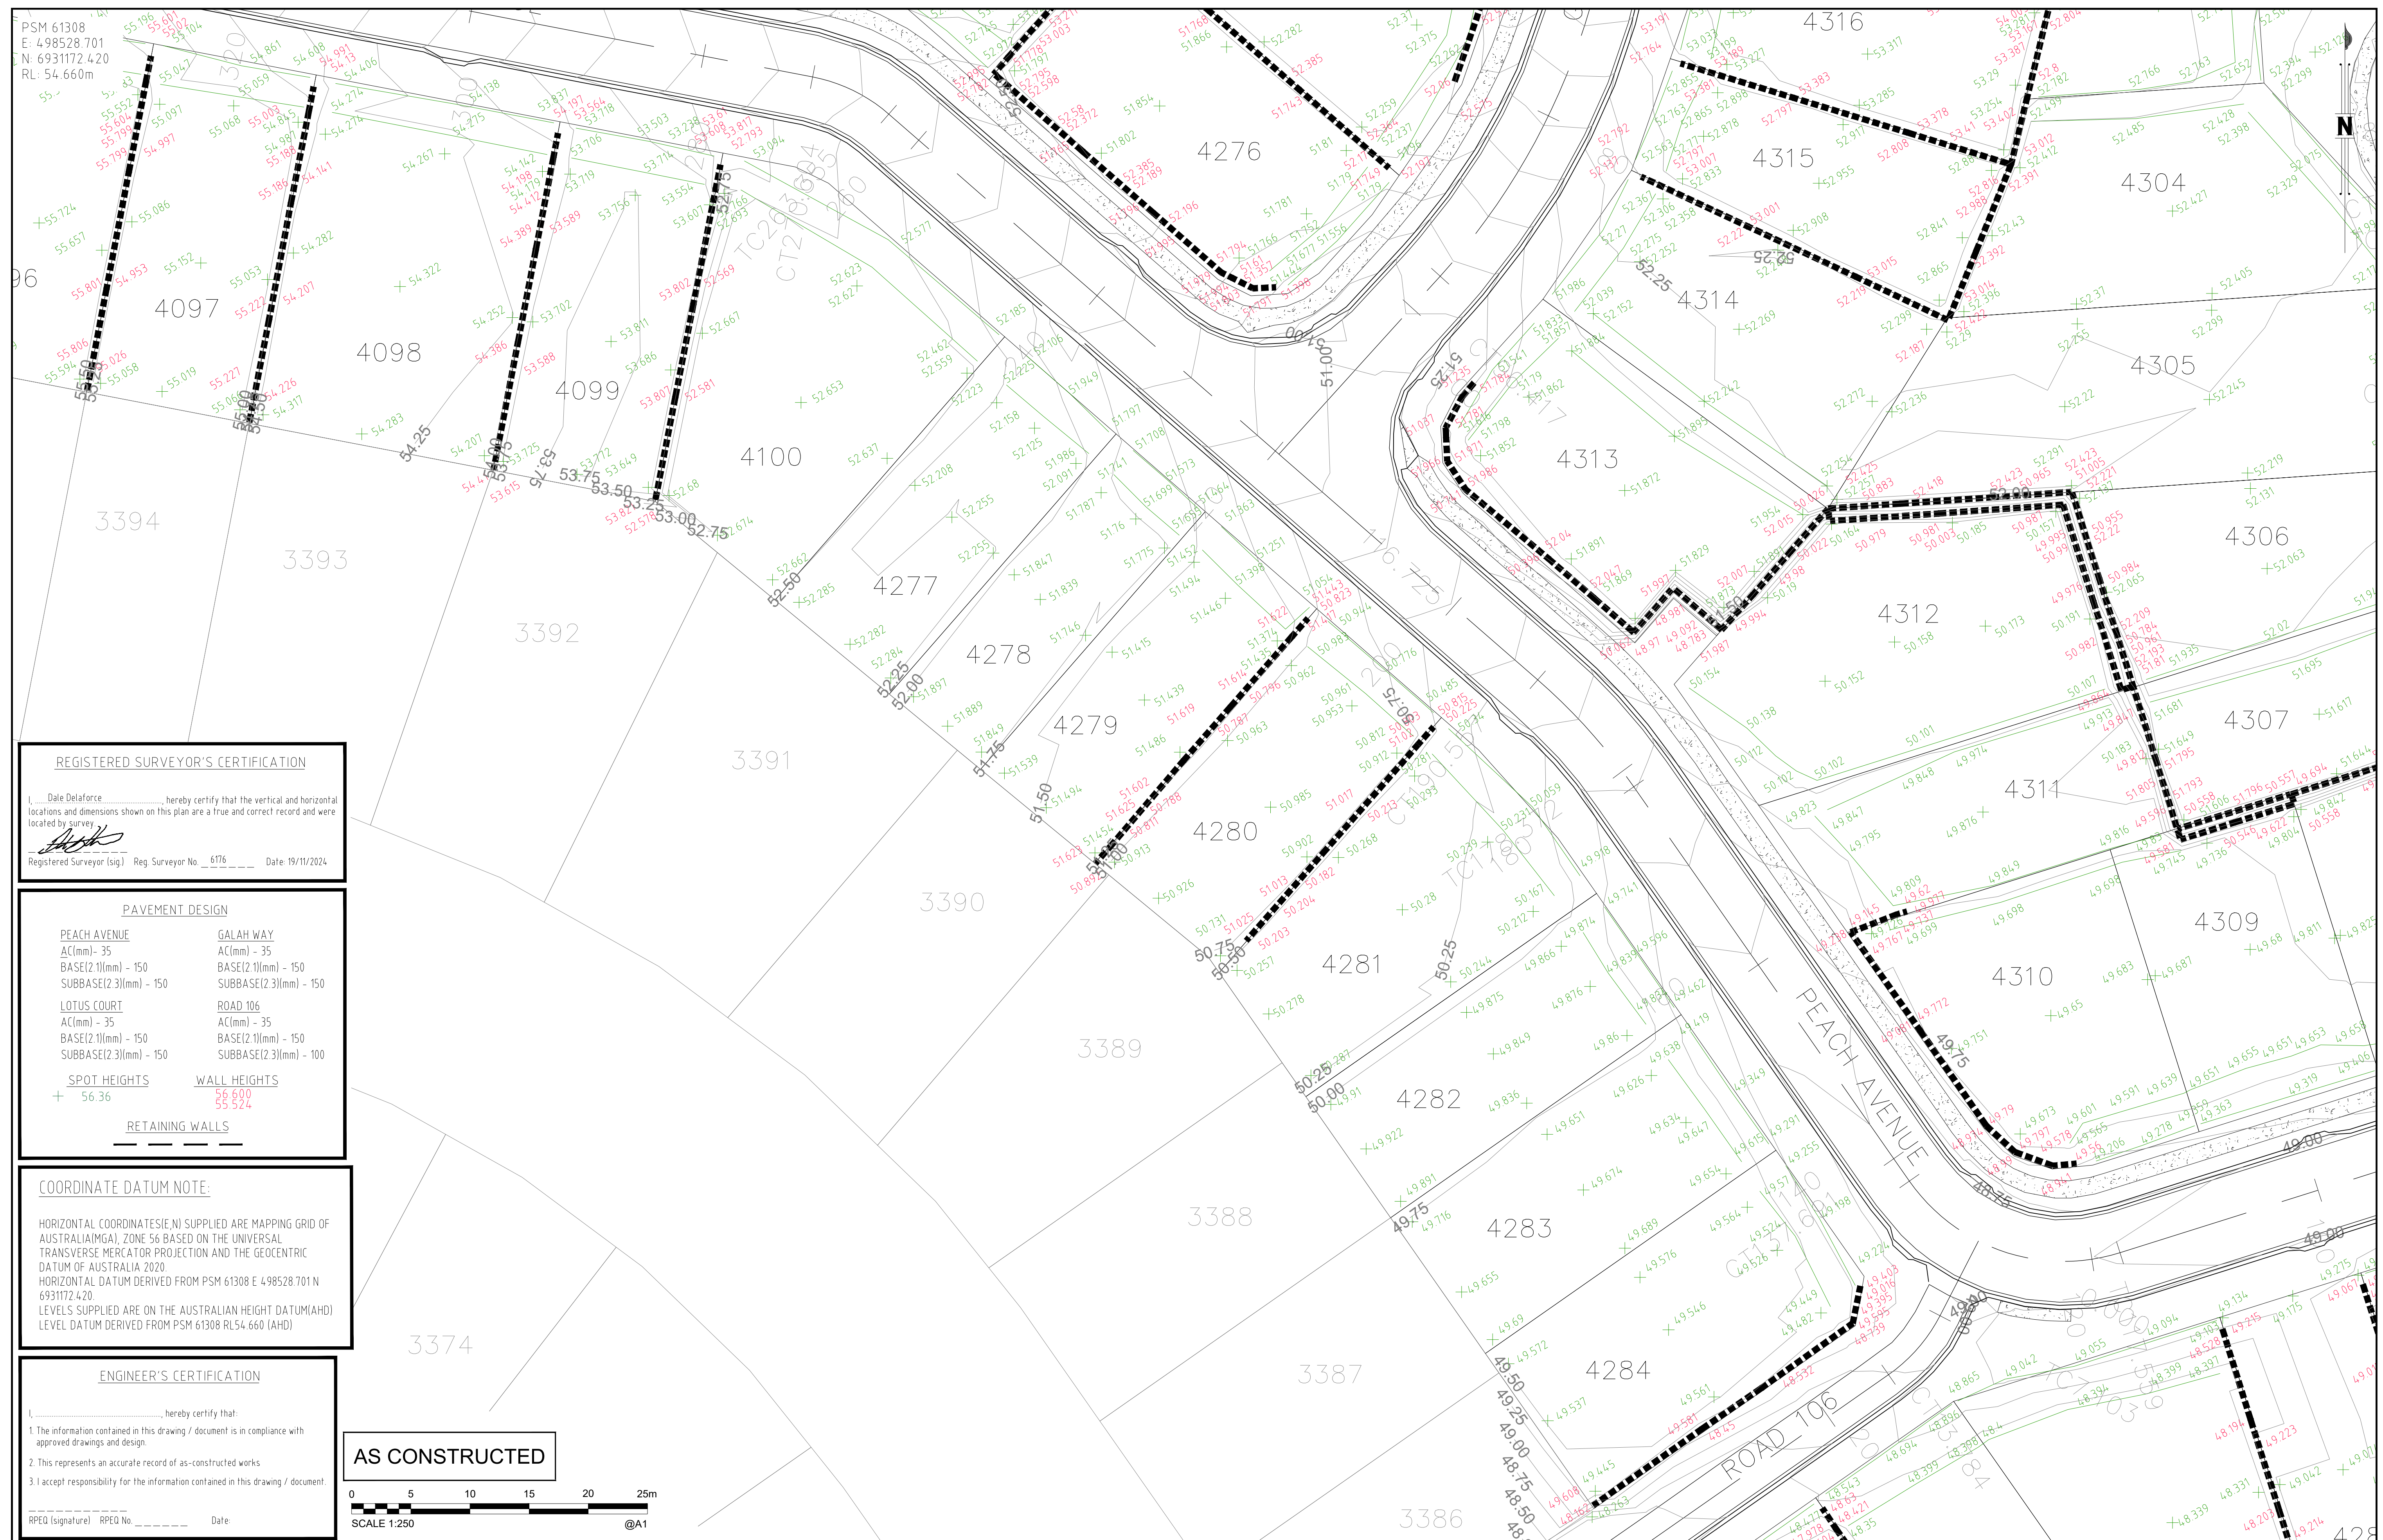

REGISTERED SURVEYOR'S CERTIFICATION

I, Dale Delaforce, hereby certify that the vertical and horizontal locations and dimensions shown on this plan are a true and correct record and were located by survey.

Registered Surveyor (sig.) _____ Reg. Surveyor No. 6176 Date: 19/11/2024

PAVEMENT DESIGN

<u>PEACH AVENUE</u>	<u>GALAH WAY</u>
AC(mm) - 35	AC(mm) - 35
BASE(2.1)(mm) - 150	BASE(2.1)(mm) - 150
SUBBASE(2.3)(mm) - 150	SUBBASE(2.3)(mm) - 150
<u>LOTUS COURT</u>	<u>ROAD 106</u>
AC(mm) - 35	AC(mm) - 35
BASE(2.1)(mm) - 150	BASE(2.1)(mm) - 150
SUBBASE(2.3)(mm) - 150	SUBBASE(2.3)(mm) - 100

SPOT HEIGHTS	WALL HEIGHTS
+ 56.36	56.600
	55.524

RETAINING WALLS

COORDINATE DATUM NOTE:

HORIZONTAL COORDINATES(E,N) SUPPLIED ARE MAPPING GRID OF AUSTRALIA(MGA), ZONE 56 BASED ON THE UNIVERSAL TRANSVERSE MERCATOR PROJECTION AND THE GEOCENTRIC DATUM OF AUSTRALIA 2020.
HORIZONTAL DATUM DERIVED FROM PSM 61308 E 4.98528 701 N 6931172 420.
LEVELS SUPPLIED ARE ON THE AUSTRALIAN HEIGHT DATUM(AHD).
LEVEL DATUM DERIVED FROM PSM 61308 RL5.4 660 (AHD)


ENGINEER'S CERTIFICATION

I, _____, hereby certify that:

1. The information contained in this drawing / document is in compliance with approved drawings and design.
2. This represents an accurate record of as-constructed works
3. I accept responsibility for the information contained in this drawing / document

RPEQ (signature) RPEQ No. Date:

AS CONSTRUCTED

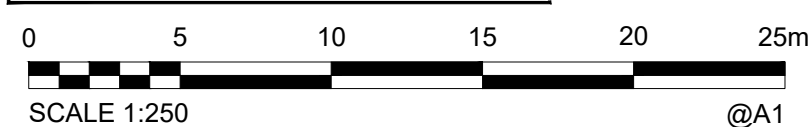

A1

							DRAWN	RDE	19/11/2024
A	19/11/2024	AS CONSTRUCTED		RDE	DAM	CW	CHECKED	DAM	19/11/2024
INDEX	DATE	REVISIONS	DRAWN	CHECKED	PASSED			INITIALS	DATE



LOGAN CITY COUNCIL

MIRVAC MIR-1003
AS CONSTRUCTED SURVEY - ROADS AND EARTHWORKS
EVERLEIGH PRECINCT 10.3C
GREENBANK QLD

SHEET 4 OF 5 SHEETS	SCALE 1:250 A1
---------------------	----------------

19/11/2024


SCALE 1:250 A1

DISCIPLINE CODE

DRAWING NO.

ASC

ASCE-RDS AND EWRDS-V4-10.3C

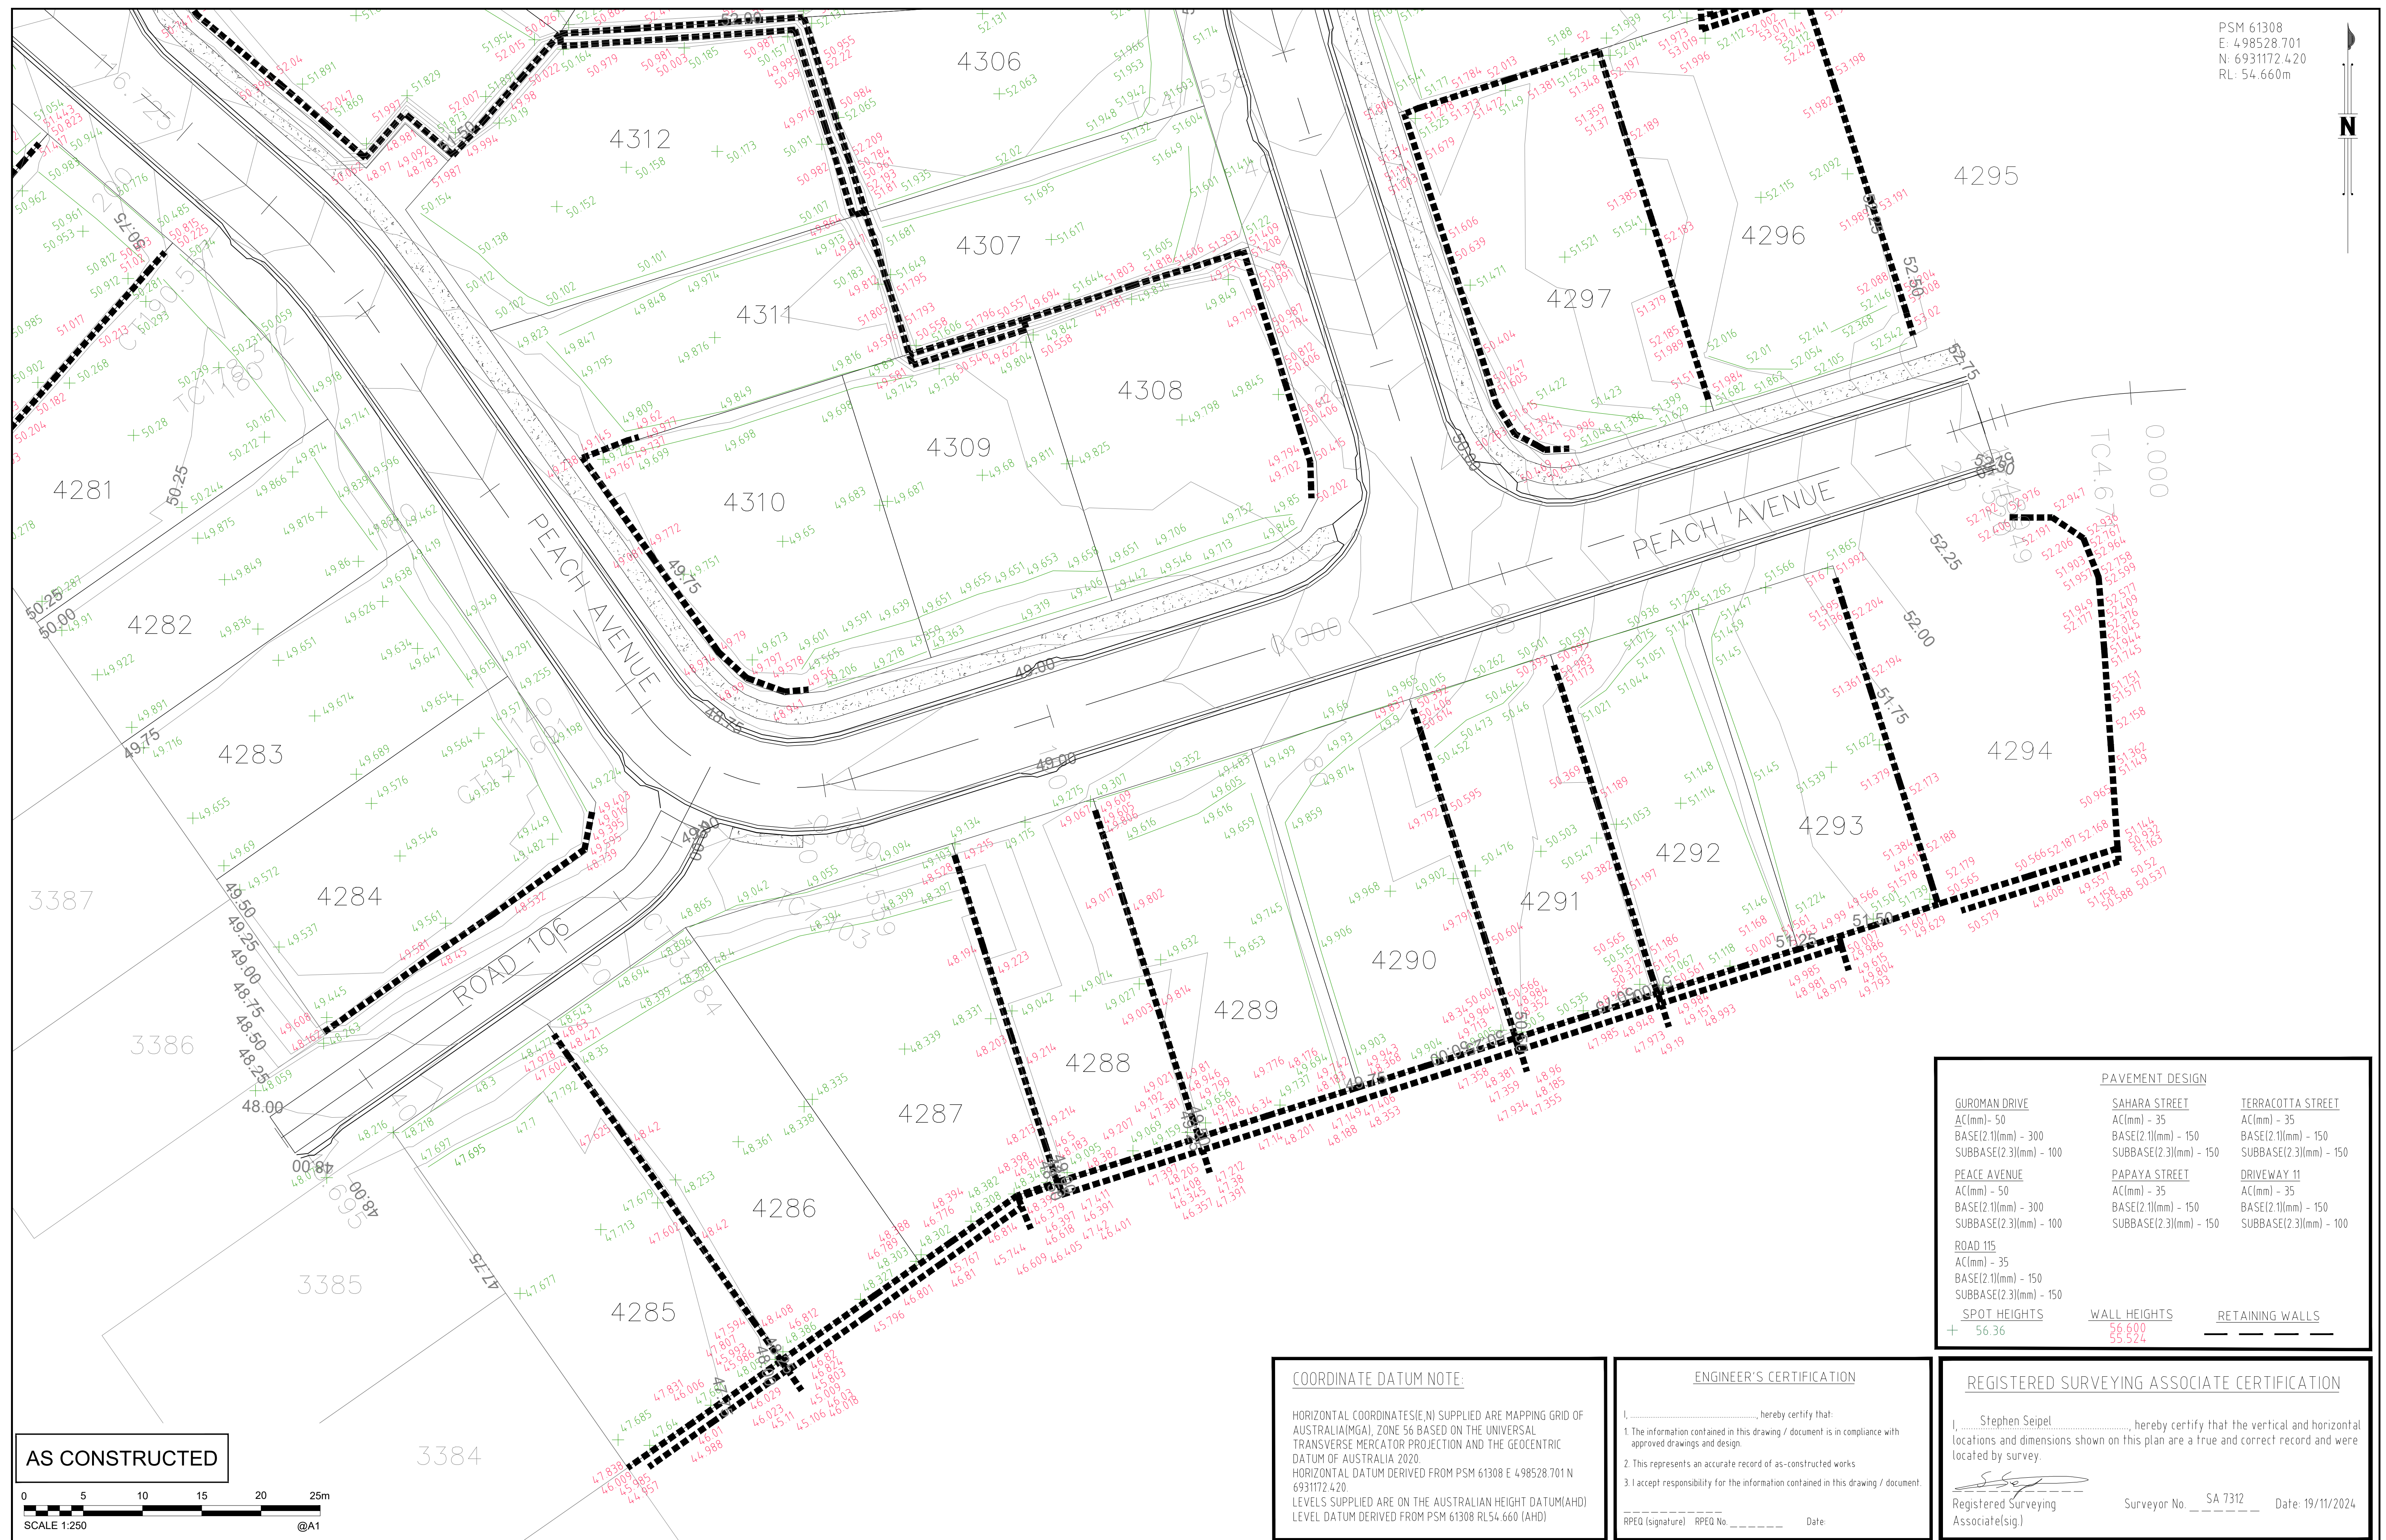[illegible]